


NOTES

1. THESE DRAWINGS ARE FROM THE CITY OF CALGARY'S RECORDS. NO WARRANTY OR REPRESENTATION AS TO THE COMPLETENESS OR ACCURACY OF SAID REPRODUCTION OR INFORMATION THEREON IS MADE.
2. AS OF FEBRUARY 28, 2006 SHALLOW UTILITY INFORMATION WILL NO LONGER BE MAINTAINED AND UPDATED ON BLOCK PROFILE DRAWINGS. PLEASE CONTACT THE SHALLOW UTILITY COMPANIES DIRECTLY FOR THE MOST CURRENT INFORMATION.
3. ALL PIPE SIZES ARE IN MILLIMETRES AND ALL DIMENSIONS ARE IN METRES UNLESS OTHERWISE NOTED.
4. ALL COORDINATES AND DISTANCES BASED ON 3TM COORDINATE SYSTEM (NAD 83).

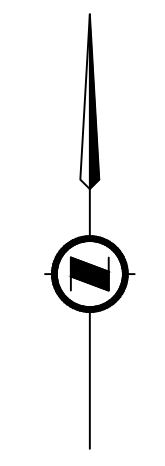


NAD 83
COORDINATES

NO.	DESCRIPTION	DATE (YYYY-MM-DD)	BY	APPD

PERMIT	SEAL

DESIGNED	BY	DATE (YYYY-MM-DD)
DRAWN		
CHECKED		

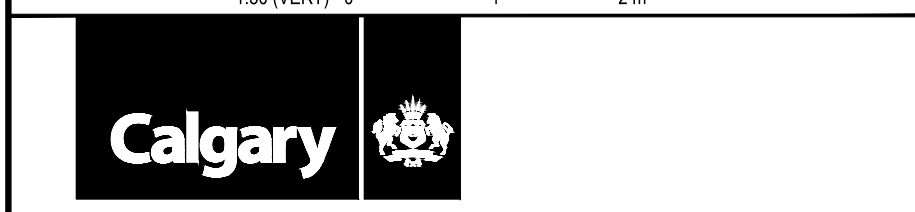

PROJECT
SEC: 36 - TWP: 25 - RGE: 02 - W 5th M

SHEET TITLE AS-BUILT BLOCK PROFILE STORM POND SAMPLE SHEET	
FILE NO.	ENG DWG NO.
SHEET ID.	SHEET NO.
BY DRAWN MH	DATE (YYYY-MM-DD) 2007-04-30
PROFILE NO. NEW	