


- ### NOTES
1. THESE DRAWINGS ARE FROM THE CITY OF CALGARY'S RECORDS. NO WARRANTY OR REPRESENTATION AS TO THE COMPLETENESS OR ACCURACY OF SAID REPRODUCTION OR INFORMATION THEREON IS MADE.
 2. AS OF FEBRUARY 28, 2006 SHALLOW UTILITY INFORMATION WILL NO LONGER BE MAINTAINED AND UPDATED ON BLOCK PROFILE DRAWINGS. PLEASE CONTACT THE SHALLOW UTILITY COMPANIES DIRECTLY FOR THE MOST CURRENT INFORMATION.
 3. ALL PIPE SIZES ARE IN MILLIMETRES AND ALL DIMENSIONS ARE IN METRES UNLESS OTHERWISE NOTED.
 4. ALL COORDINATES AND DISTANCES BASED ON 3TM COORDINATE SYSTEM (NAD 83).

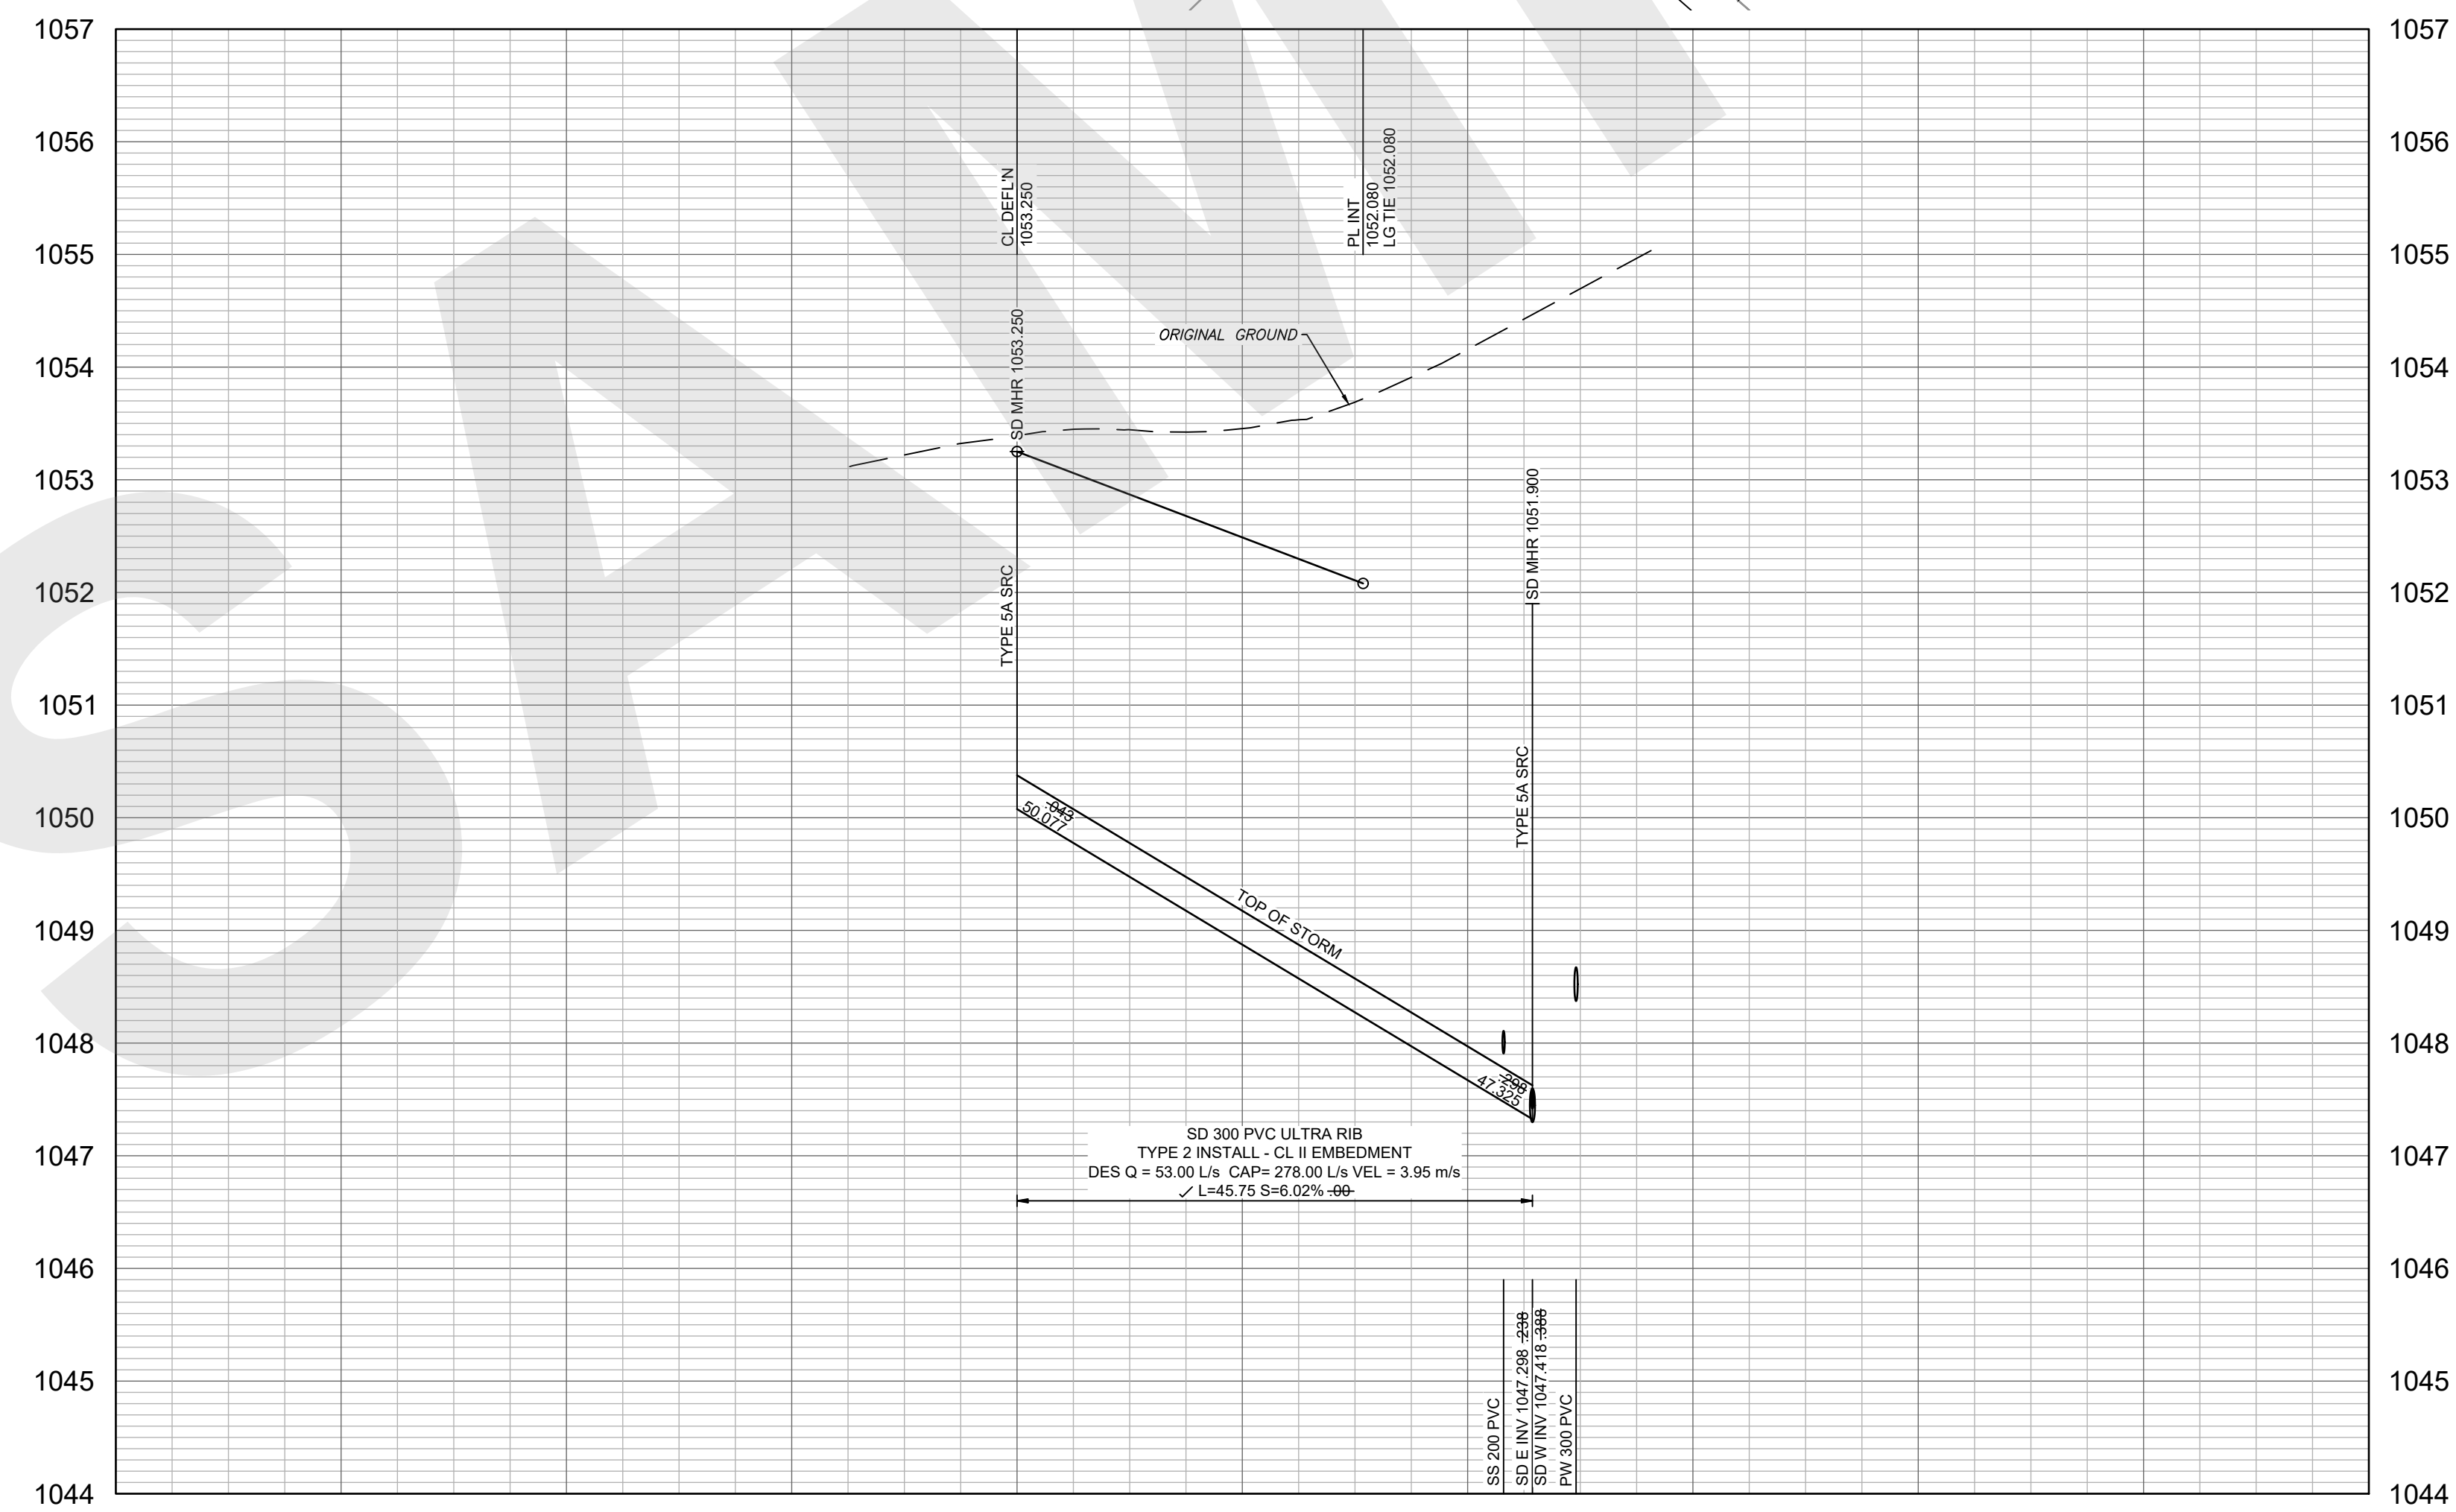

NO.	DESCRIPTION	DATE (YYYY-MM-DD)	BY	APPD
PERMIT				
		SEAL		
		DATE (YYYY-MM-DD)		
DESIGNED				
DRAWN				
CHECKED				
SCALE		1:50 (HORZ) 0 10 20 m		
		1:50 (VERT) 0 1 2 m		
PROJECT				
SEC: 16 - TWP: 22 - RGE: 29 - W 4th M				
SHEET TITLE				
AS-BUILT BLOCK PROFILE UR/W SAMPLE SHEET				
FILE NO.		ENG DWG NO.		
SHEET ID.		SHEET NO.		
BY		DATE (YYYY-MM-DD)		PROFILE NO.
DRAWN JRP		2010-03-31		64

THESE AS-BUILT DRAWING SAMPLES ARE INTENDED TO ILLUSTRATE THE NEW CAD STANDARDS AND ARE FOR REFERENCE PURPOSES ONLY. PLEASE CONFIRM WITH YOUR APPROPRIATE CITY OF CALGARY CONTACT FOR SPECIFIC CONTENT REQUIREMENTS.