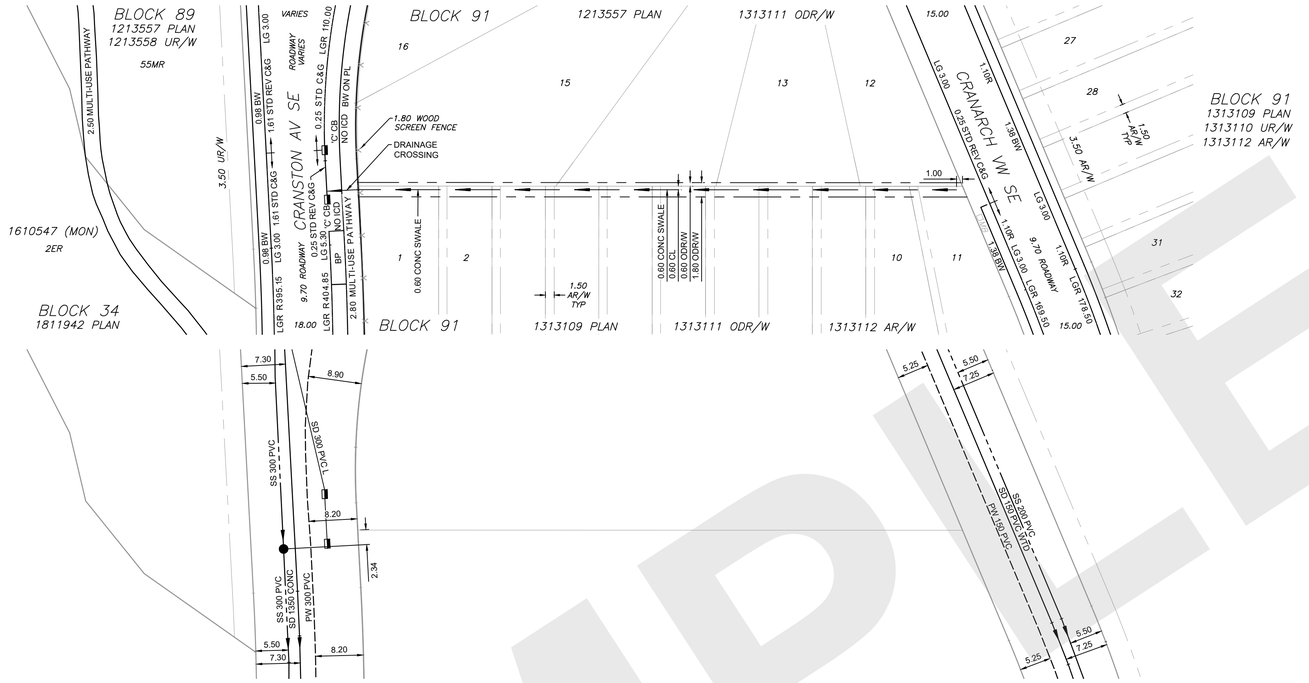

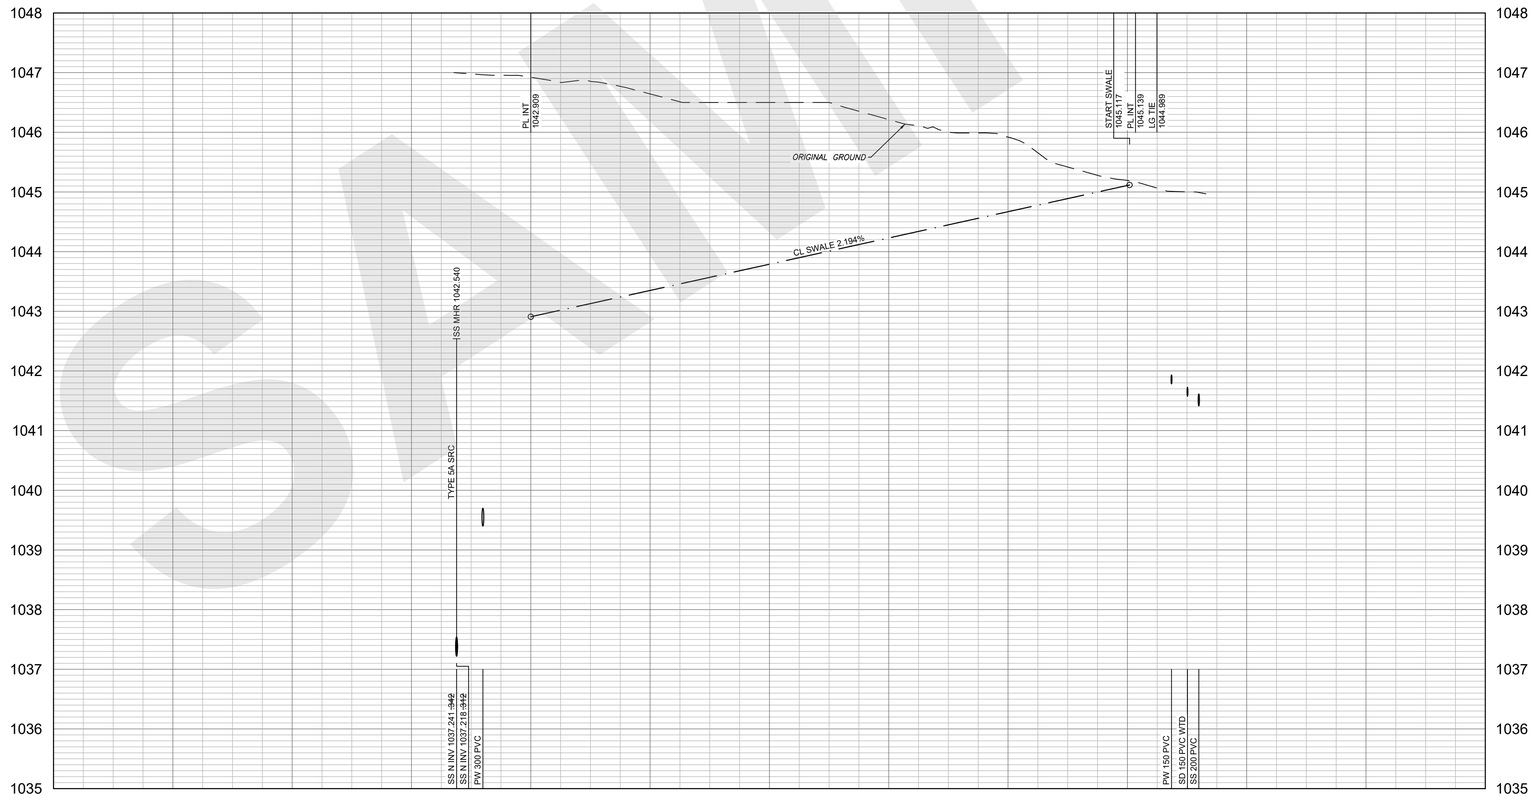

NOTES

1. THESE DRAWINGS ARE FROM THE CITY OF CALGARY'S RECORDS. NO WARRANTY OR REPRESENTATION AS TO THE COMPLETENESS OR ACCURACY OF SAID REPRODUCTION OR INFORMATION THEREON IS MADE.
2. AS OF FEBRUARY 28, 2006 SHALLOW UTILITY INFORMATION WILL NO LONGER BE MAINTAINED AND UPDATED ON BLOCK PROFILE DRAWINGS. PLEASE CONTACT THE SHALLOW UTILITY COMPANIES DIRECTLY FOR THE MOST CURRENT INFORMATION.
3. ALL PIPE SIZES ARE IN MILLIMETRES AND ALL DIMENSIONS ARE IN METRES UNLESS OTHERWISE NOTED.
4. ALL COORDINATES AND DISTANCES BASED ON 3TM COORDINATE SYSTEM (NAD 83).

ALBERTA ONECALL

NAD 83
COORDINATES

NO.	DESCRIPTION	DATE (YYYY-MM-DD)	BY	APPD

PERMIT

SEAL

	BY	DATE (YYYY-MM-DD)
DESIGNED		
DRAWN		
CHECKED		

SCALE 1:500 (HORZ) 0 10 20 m
1:50 (VERT) 0 1 2 m

Calgary

PROJECT

SEC: 16 - TWP: 22 - RGE: 29 - W 4th M

SHEET TITLE

AS-BUILT BLOCK PROFILE ODR/W - WITH SWALE SAMPLE SHEET

FILE NO.	ENG DWG NO.
SHEET ID.	SHEET NO.

	BY	DATE (YYYY-MM-DD)	PROFILE NO.
DRAWN	MH	2012-06-01	NEW

ISC: SHEET SIZE ANSI D 25 mm 0

SAMPLE

THESE AS-BUILT DRAWING SAMPLES ARE INTENDED TO ILLUSTRATE THE NEW CAD STANDARDS AND ARE FOR REFERENCE PURPOSES ONLY. PLEASE CONFIRM WITH YOUR APPROPRIATE CITY OF CALGARY CONTACT FOR SPECIFIC CONTENT REQUIREMENTS.