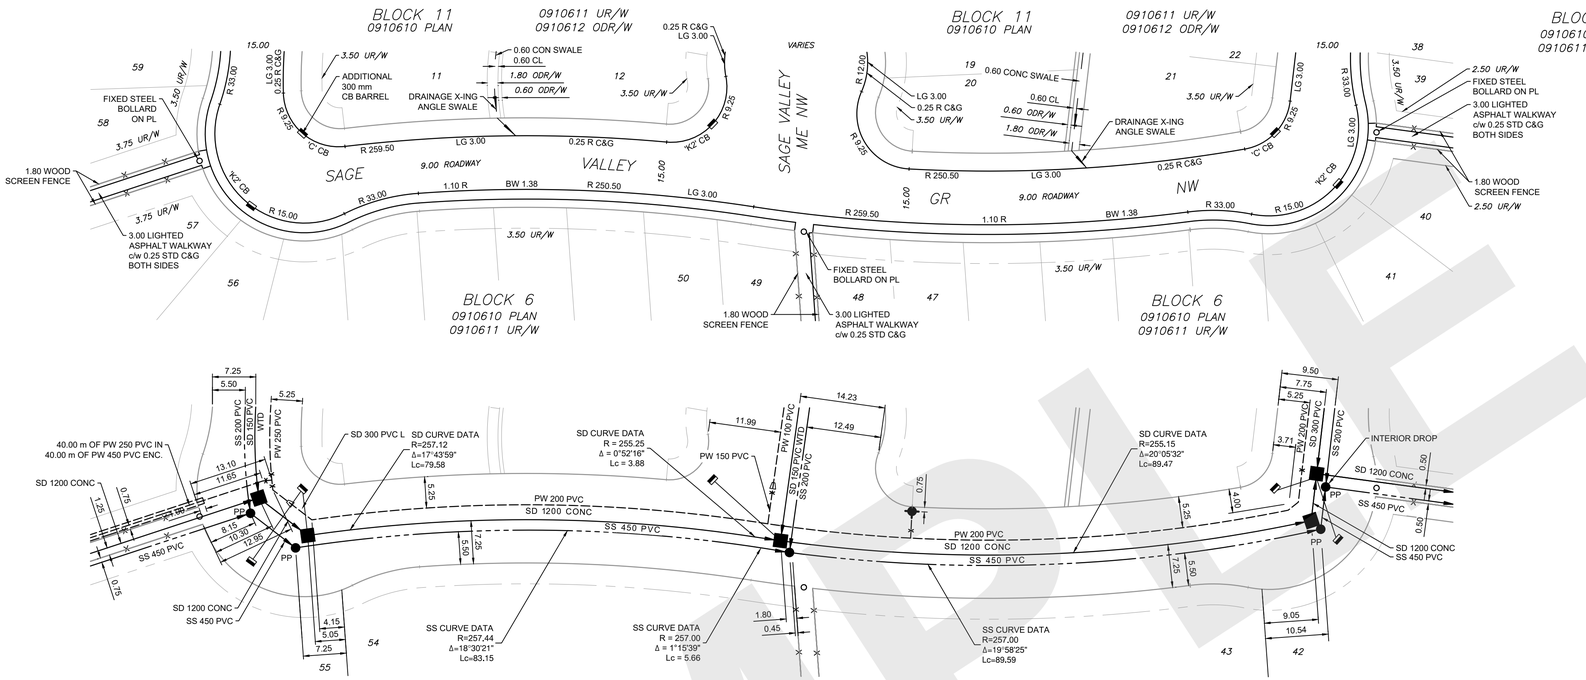

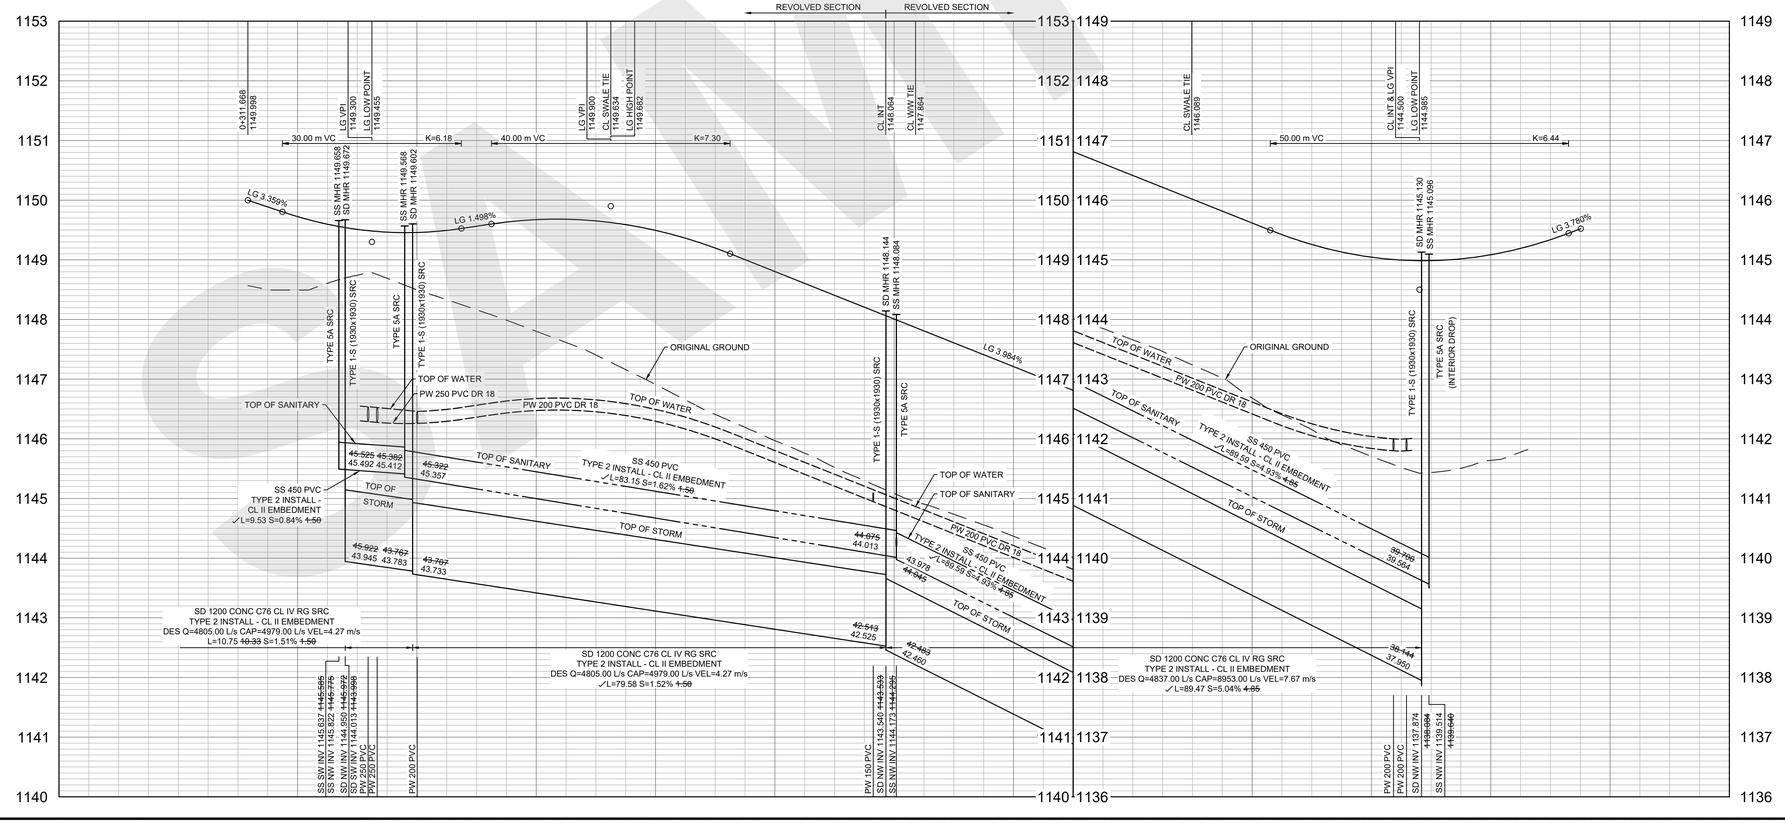

NOTES

1. THESE DRAWINGS ARE FROM THE CITY OF CALGARY'S RECORDS. NO WARRANTY OR REPRESENTATION AS TO THE COMPLETENESS OR ACCURACY OF SAID REPRODUCTION OR INFORMATION THEREON IS MADE.
2. AS OF FEBRUARY 28, 2006 SHALLOW UTILITY INFORMATION WILL NO LONGER BE MAINTAINED AND UPDATED ON BLOCK PROFILE DRAWINGS. PLEASE CONTACT THE SHALLOW UTILITY COMPANIES DIRECTLY FOR THE MOST CURRENT INFORMATION.
3. ALL PIPE SIZES ARE IN MILLIMETRES AND ALL DIMENSIONS ARE IN METRES UNLESS OTHERWISE NOTED.
4. ALL COORDINATES AND DISTANCES BASED ON 3TM COORDINATE SYSTEM (NAD 83).

ALBERTA ONECALL

NAD 83
COORDINATES

NO.	DESCRIPTION	DATE (YYYY-MM-DD)	BY	APPD

PERMIT

SEAL

	BY	DATE (YYYY-MM-DD)
DESIGNED		
DRAWN		
CHECKED		

SCALE 1:500 (HORZ) 0 10 20 m
1:50 (VERT) 0 1 2 m

Calgary

PROJECT

SEC: 26 - TWP: 23 - RGE: 29 - W 4th M

SHEET TITLE

AS-BUILT BLOCK PROFILE LOCAL STREET SAMPLE SHEET

FILE NO.	ENG DWG NO.
SHEET ID.	SHEET NO.

	BY	DATE (YYYY-MM-DD)	PROFILE NO.
DRAWN	DEF	2019-01-13	456

ISC: SHEET SIZE ANSI D 25 mm 0

THESE AS-BUILT DRAWING SAMPLES ARE INTENDED TO ILLUSTRATE THE NEW CAD STANDARDS AND ARE FOR REFERENCE PURPOSES ONLY. PLEASE CONFIRM WITH YOUR APPROPRIATE CITY OF CALGARY CONTACT FOR SPECIFIC CONTENT REQUIREMENTS.